


NLCA LATERAL AS BUILT

EXAMPLE

- A - TRAP FROM HOME
4 FEET
- B - 2 POINT LATERAL
MEASUREMENT #
3 FEET
FROM LEFT CORNER
OF HOME
- C - 2 POINT LATERAL
MEASUREMENT #
28 FEET
FROM RIGHT CORNER
OF HOME

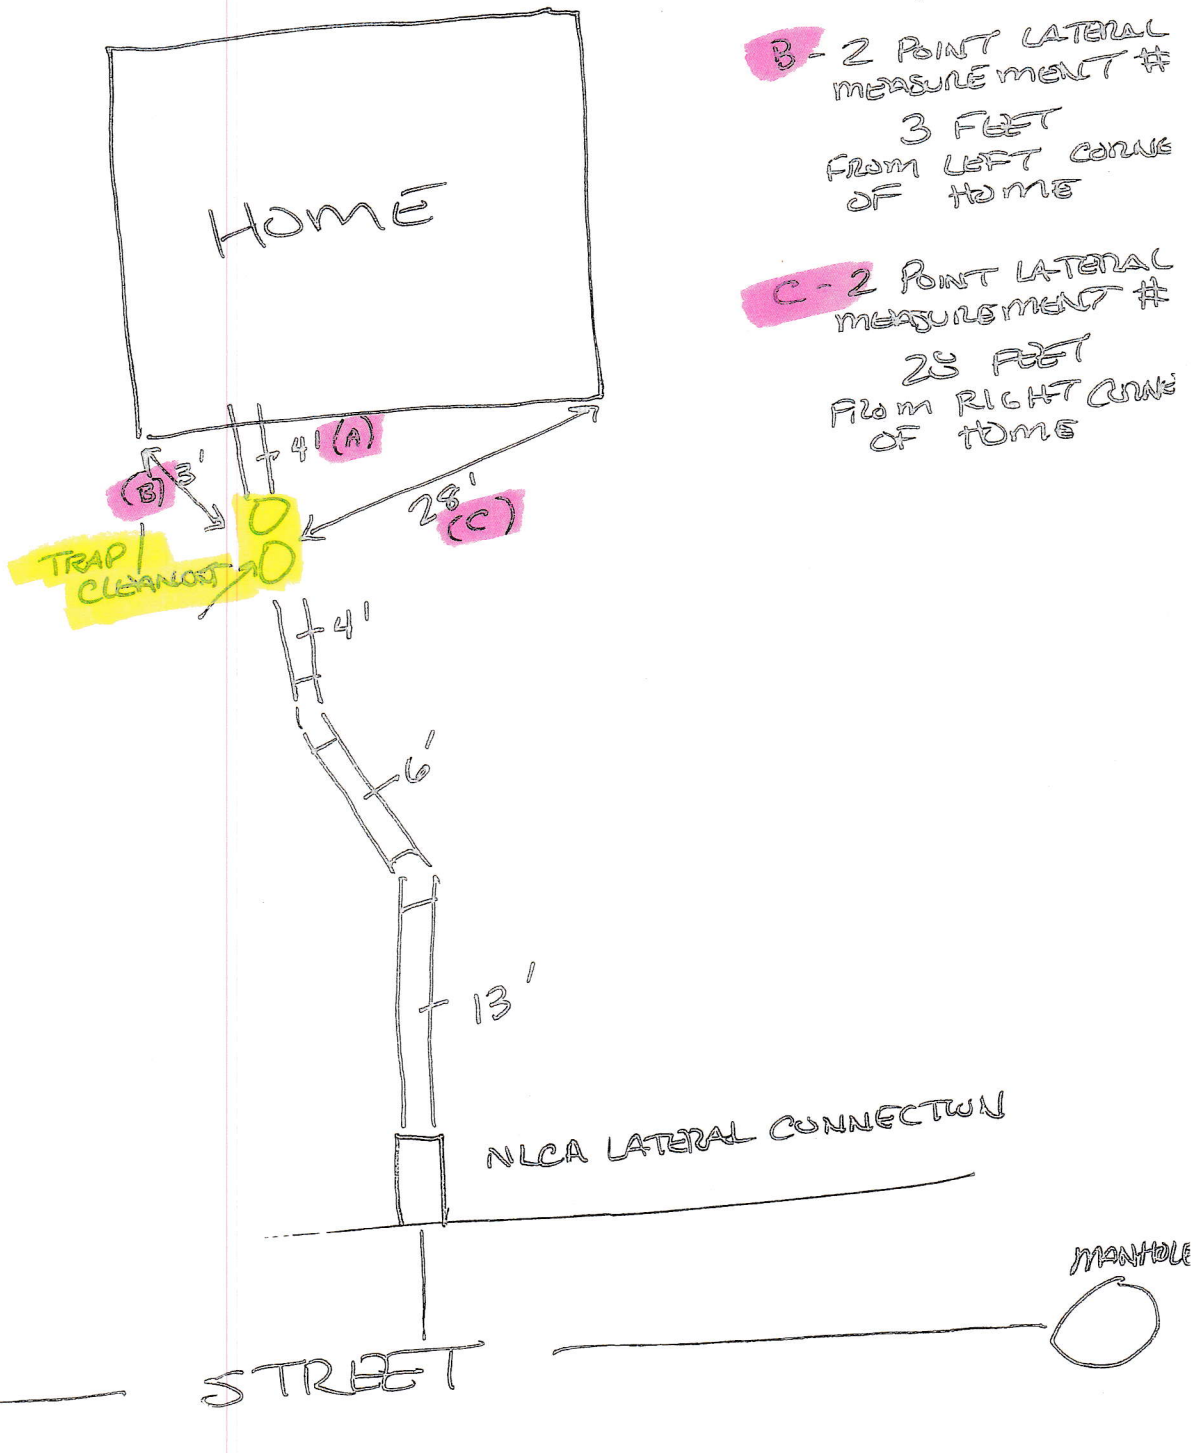

MANHOLE

STREET

MANHOLE

NLCA LATERAL CONNECTION

NLCA LATERAL AS BUILT

FILLED IN BY DEVELOPER / BUILDER

